

2567 ala 1887
RAW 7470
83

Drawer 38
Sheet 19

File with
2477 0220 1887

Description of Proposed Light House Reservation


Extrakt from letters from Lieut John M. Ellis, Eng^r 34th L. H. Dist.
to Col. J. I. Casey, U.S. Eng^r, Jan. 22^d 1887.


"The boundaries of the proposed reservation are indicated in red on the tracing and the following is the description:
"All that parcel of land lying at the Northern extremity of the island, bounded as follows: Beginning at a point A on the outer crest of the sea-wall distant 150 feet South-Easterly from the intersection B of said outer crest with the prolongation of the South-East face of the brick building known as the hospital, and running South-Westerly at right angles to said outer crest of sea-wall for a distance of 200 feet to C, thence Westerly at an angle of 128° 45' with the first course for a distance of 220 feet, more or less, to low water line D; thence along low water line Northerly around the northern end of the island thence South-Easterly to the point E at the intersection of low water line with the prolongation of the first course thence along this prolongation to the point of beginning, A;
"Embracing the entire northern end of the island and containing about one and fifteen hundredths acres of upland."

MAP
of
Bedlow's Island
NEW YORK HARBOR
From Survey of Lieut Frederick L. Prime, January 20, 1851.
With corrections & additions to date, Nov. 1886.
Scale 25 feet to 1 inch.

Engineer Office, U.S. Army,
New York, February 1, 1887.
Sent to the Chief of Engineers with letter of
this date.
(Sd) D. C. Houston
Lieut. Col. of Engineers.

Office of Light House Engineer 34th Dist.
January 22, 1887.
Accompanying letter of this date
to Col. J. I. Casey, Corps of Eng^r U.S. Army.
(Sd) John M. Ellis
1st Lt. Eng^r, Eng^r 34th L. H. Dist.

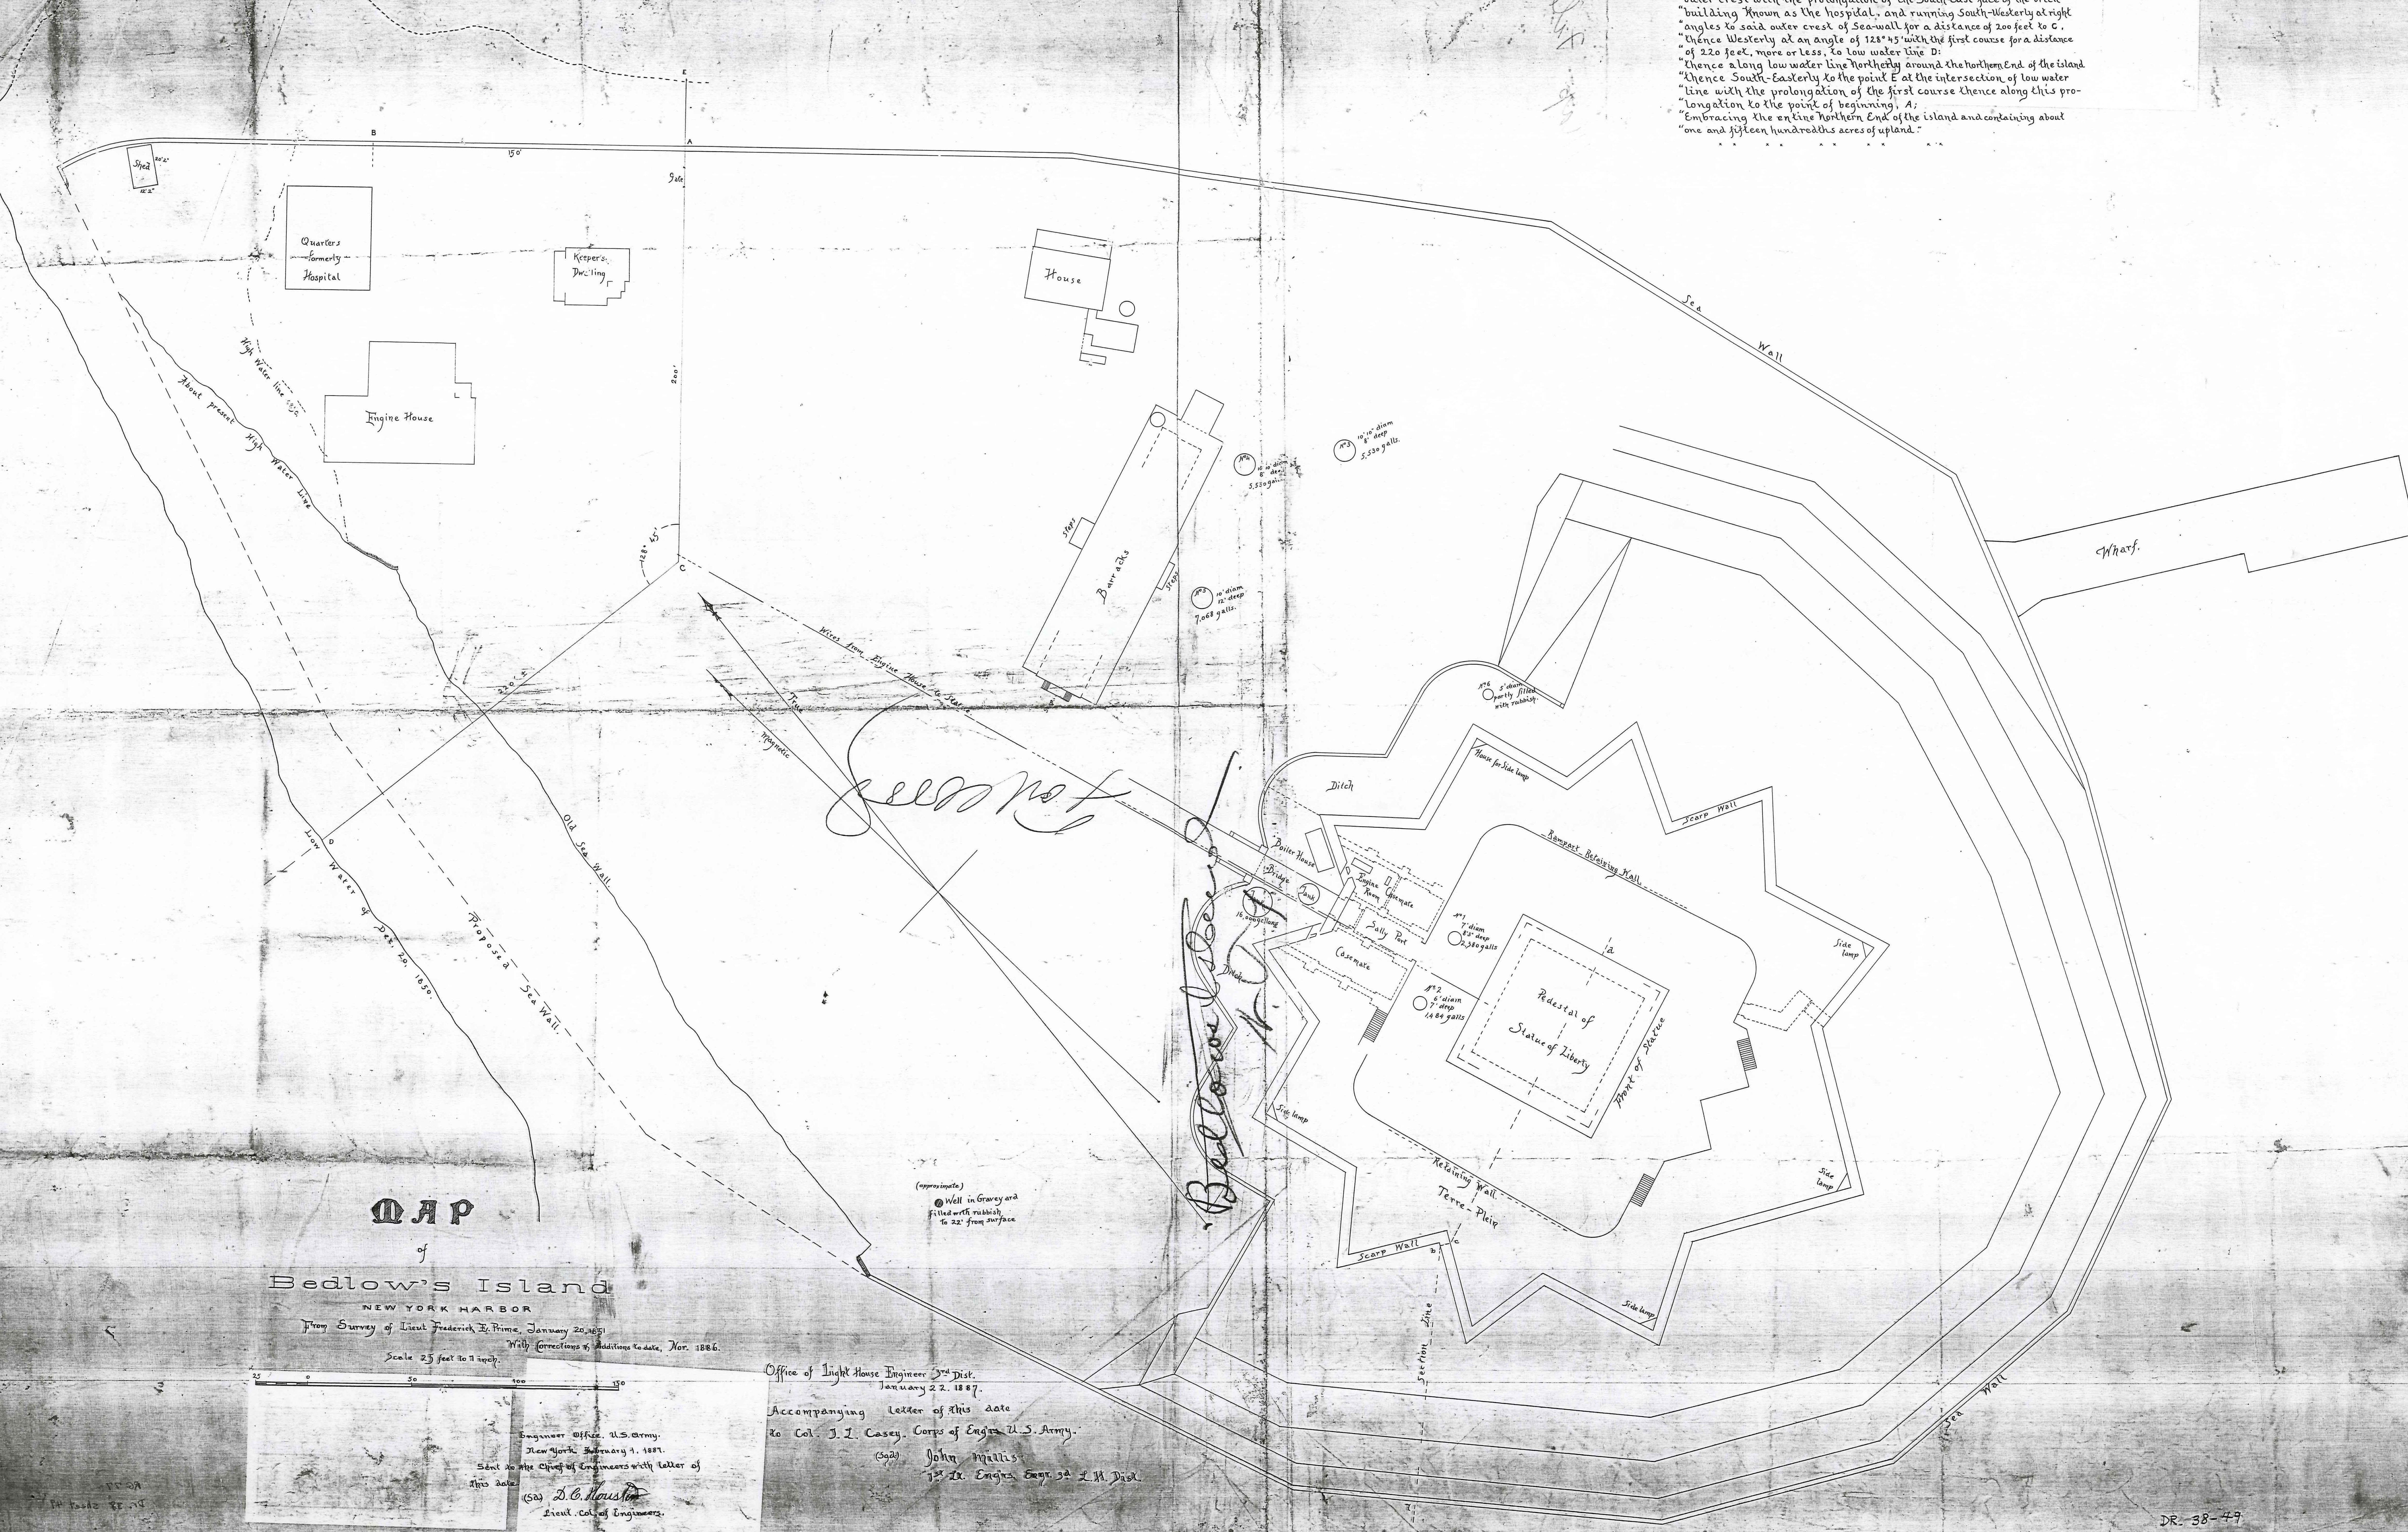

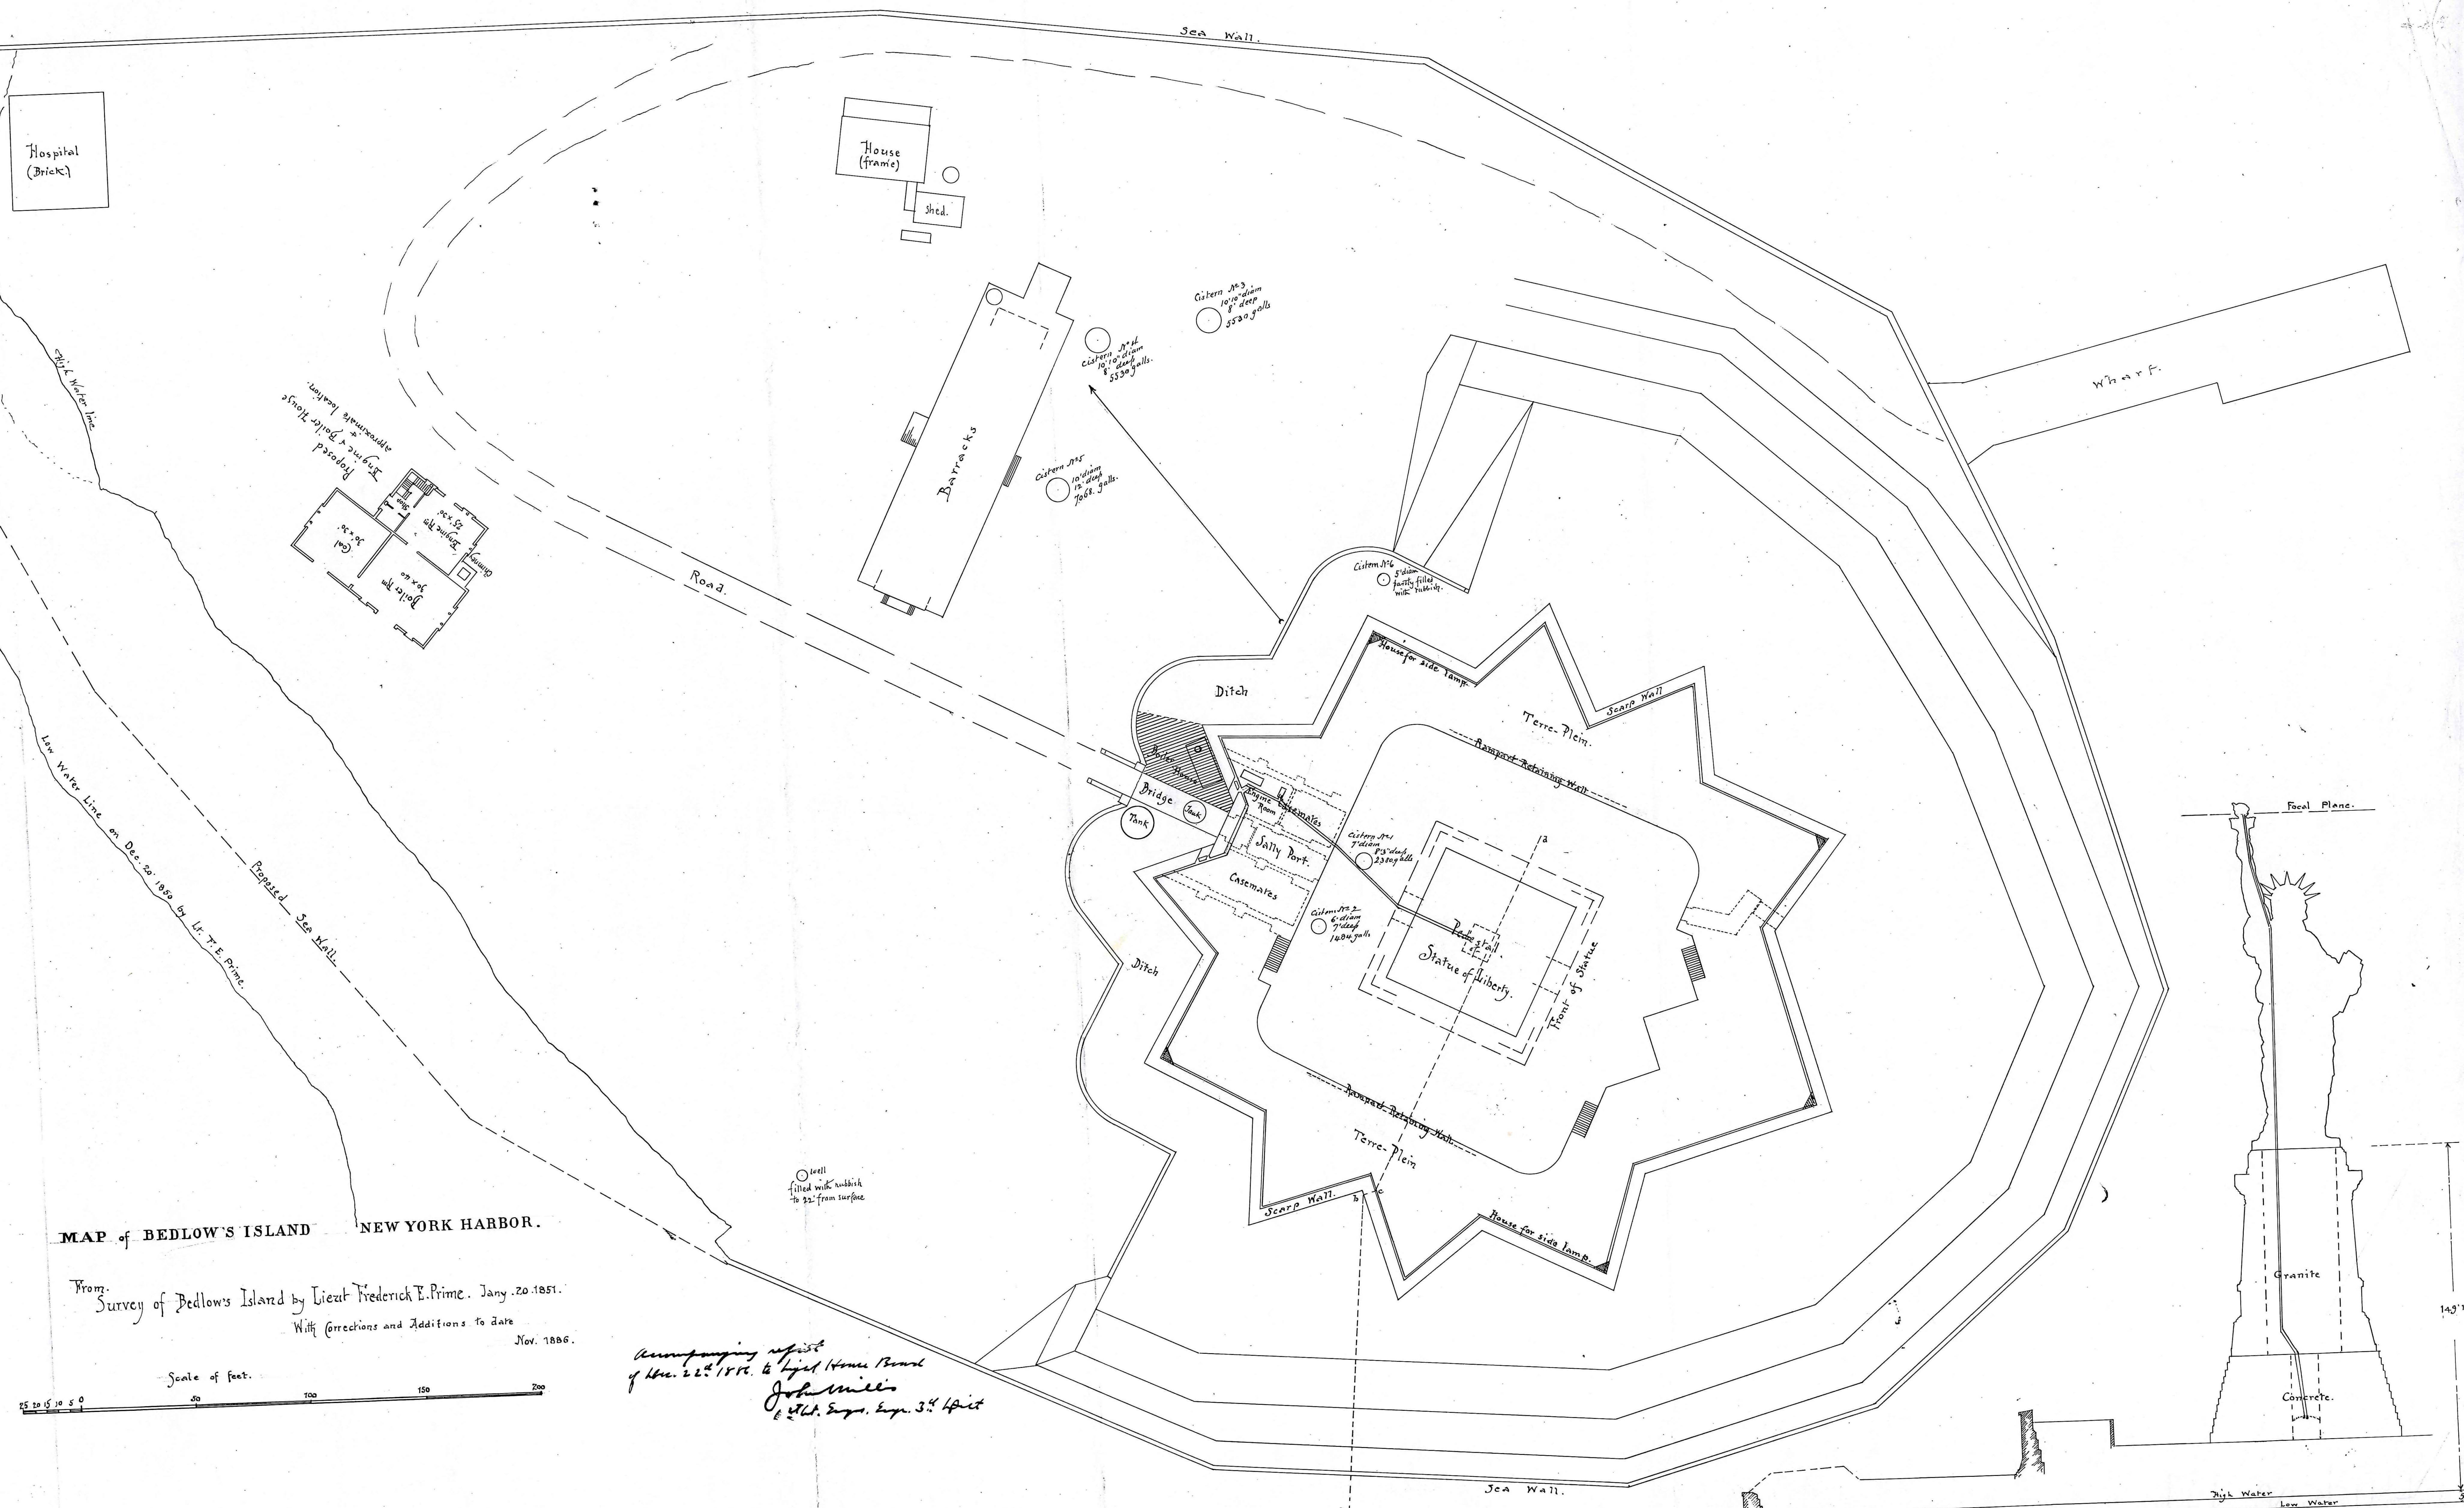


MAP of BEDLOW'S ISLAND NEW YORK HARBOR.

From
Survey of Bedlow's Island by Lieut Frederick T. Prime. Jan'y. 20. 1851.
With Corrections and Additions to date
Nov. 1886

Accompanying report
of Dec. 22^d 1896. to Light House Board
John Miller
Engr. 34 1/2 ft

3-19 B-B-3 section on line abcd.

RECEIVED
1952
U.S. HOUSE OF REPRESENTATIVES

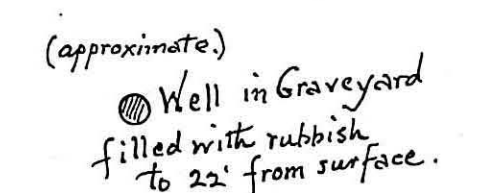

From Survey of Lieut Frederick B. Prime January 20, 1891.
With Corrections & Additions to date. Nov. 1896
+ Scale 25 feet to 1 inch.

Accompanying letter of this date
to Col. J. L. Casey, Corps of Engs. U. S. Army.

John Miller,
1st Lt. Engs. Reg. 3rd L. H. Volt.

3rd Dist. 19 B

3-19B-B-28