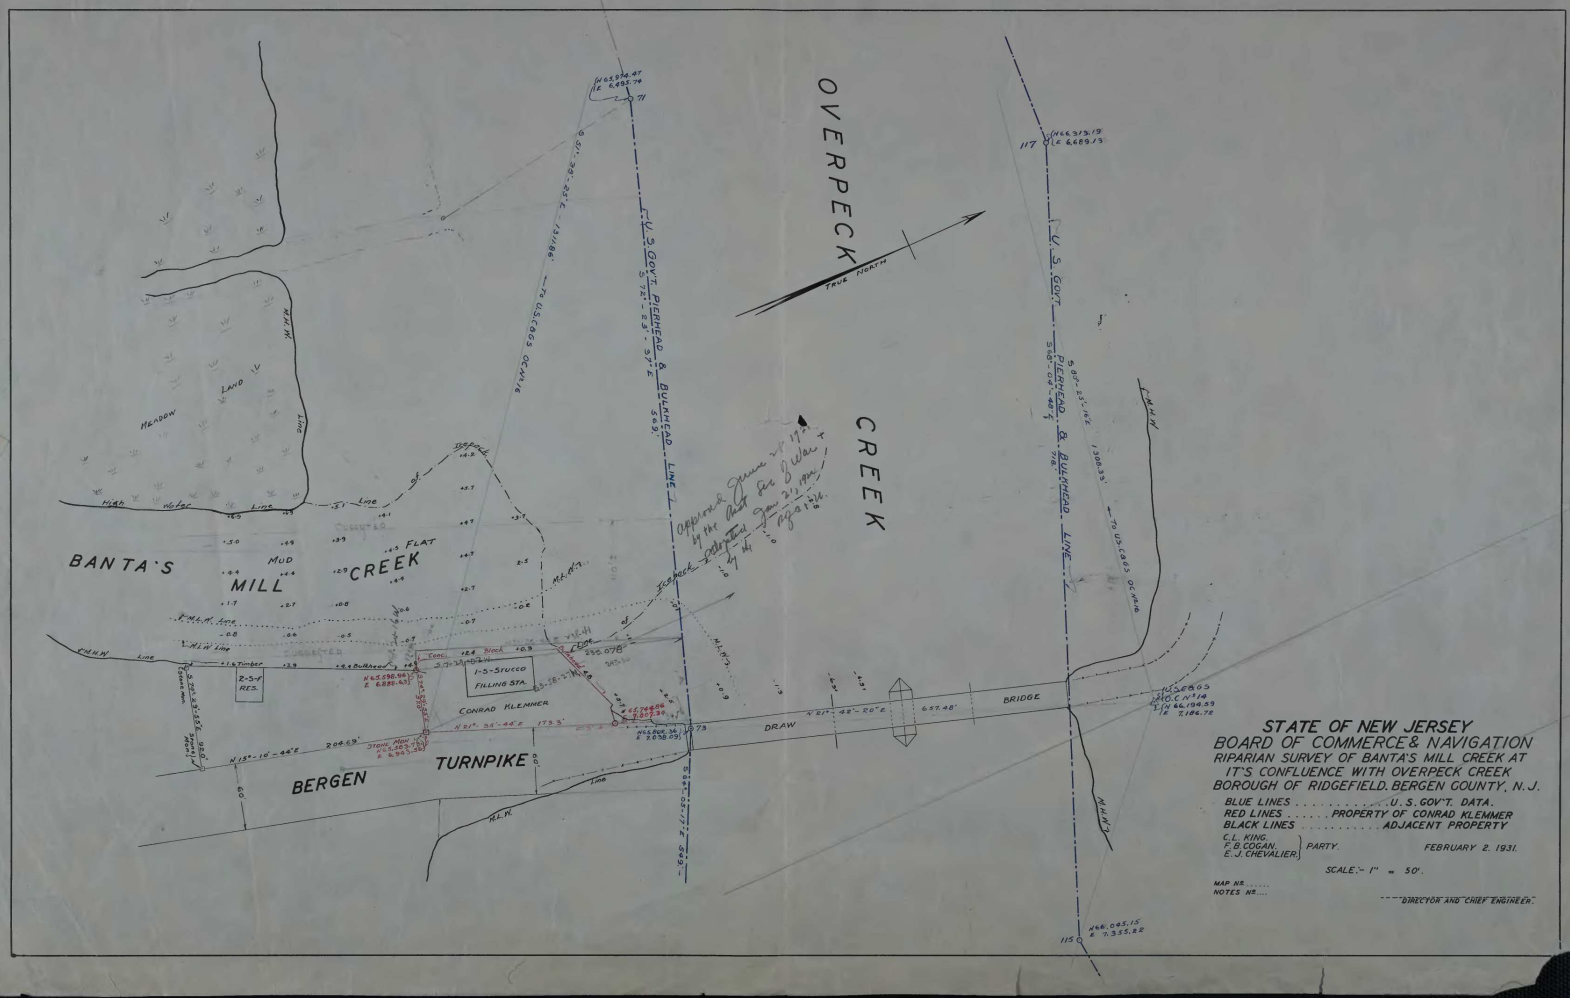

STATE OF NEW JERSEY
BOARD OF COMMERCE & NAVIGATION
RIPARIAN SURVEY OF BANTA'S MILL CREEK AT
IT'S CONFLUENCE WITH OVERPECK CREEK
BOROUGH OF RIDGEFIELD. BERGEN COUNTY, N.J.

BLUE LINES ..... U.S. GOV'T. DATA.
RED LINES ..... PROPERTY OF CONRAD KLEMMER
BLACK LINES ..... ADJACENT PROPERTY

C.L. KING.
F.B. COGAN.
E.J. CHEVALIER. } PARTY. FEBRUARY 2. 1931.

SCALE:- 1" = 50'.

MAP No. ....
NOTES No. ....

DIRECTOR AND CHIEF ENGINEER.